
 
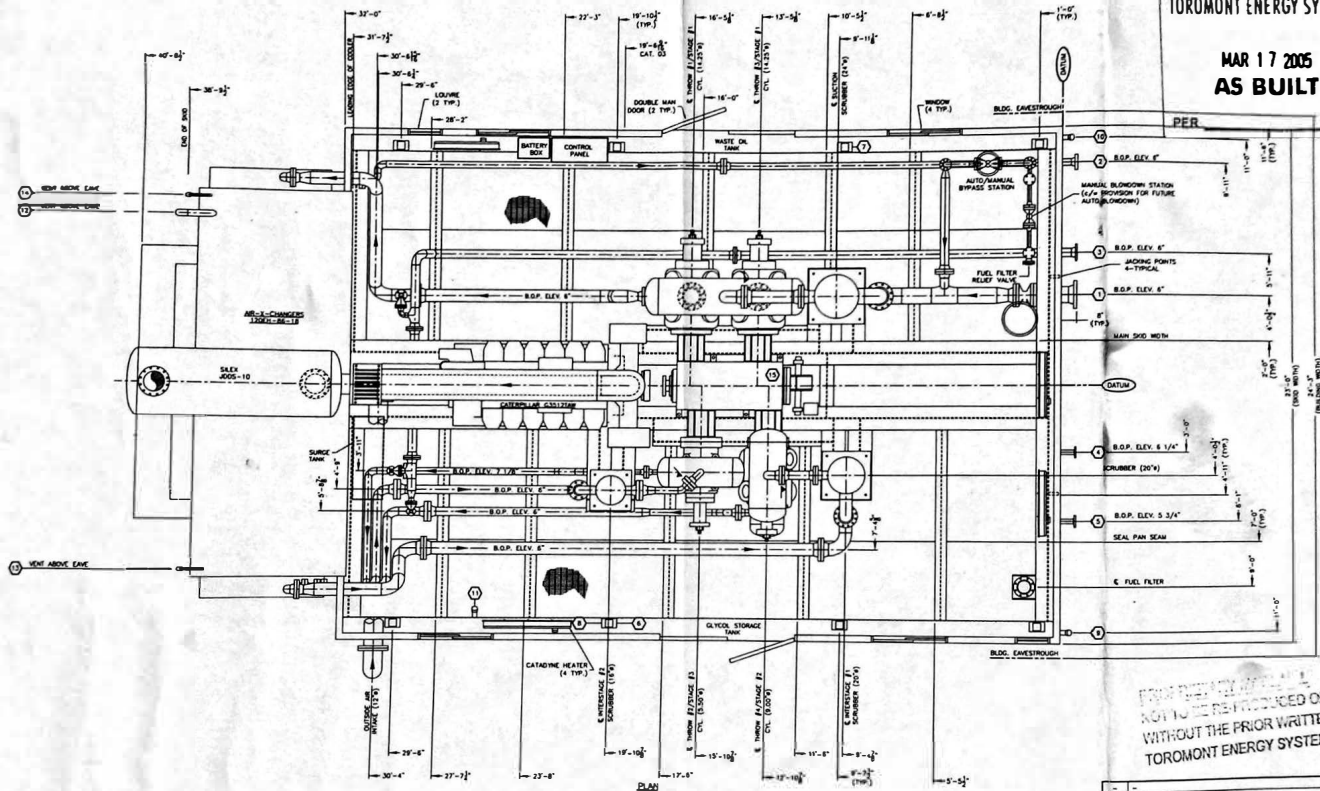 


TOROMONT ENERGY SYSTEMS

MAR 17 2005
AS BUILT





THROW #4 / STAGE #2
9.00" CYLINDERS

PROPRIETARY MATERIAL
NOT TO BE REPRODUCED OR DISTRIBUTED
WITHOUT THE PRIOR WRITTEN CONSENT OF
TERRACONT ENERGY SYSTEMS INC.

0	ISSUED FOR CONSTRUCTION	02/26/03	VS
Rev	REVISION	DATE	BY

PROPRIETARY MATERIAL: NOT TO BE REPRODUCED OR DISTRIBUTED WITHOUT THE PRIOR WRITTEN
 PERMISSION OF THE ENERGY RESEARCH CORPORATION



