

V-101

HORIZONTAL SEPARATOR

60"ID x 20'-0" S/S
720 PSIG @ 130°F, 1/8" C.A.
X-RAY: RT-2, MDMT: -20°F
DESIGNED 3, DRESSED 2 PHASE
REGISTERED IN AB

V-102


FUEL GAS SCRUBBER

8 5/8"OD x 2'-9" S/S
285 PSIG @ 100°F, 1/8" C.A.
X-RAY: RT-2, MDMT: -20°F
c/w INTEGRAL HLSD
REGISTERED IN AB, BC, SASK

BH-801/802

BUILDING HEATERS

CATADYNE: WX 24x36
c/w 30' OF 12 VOLT START CABLES, VENT HOOD,
GRILL, TAMPER PROOF SAFETY SHUTOFF,
THERMOSTAT, SWEET NATURAL GAS,
912 & MAXITROL REGULATOR
SIDE MOUNT CONTROLS

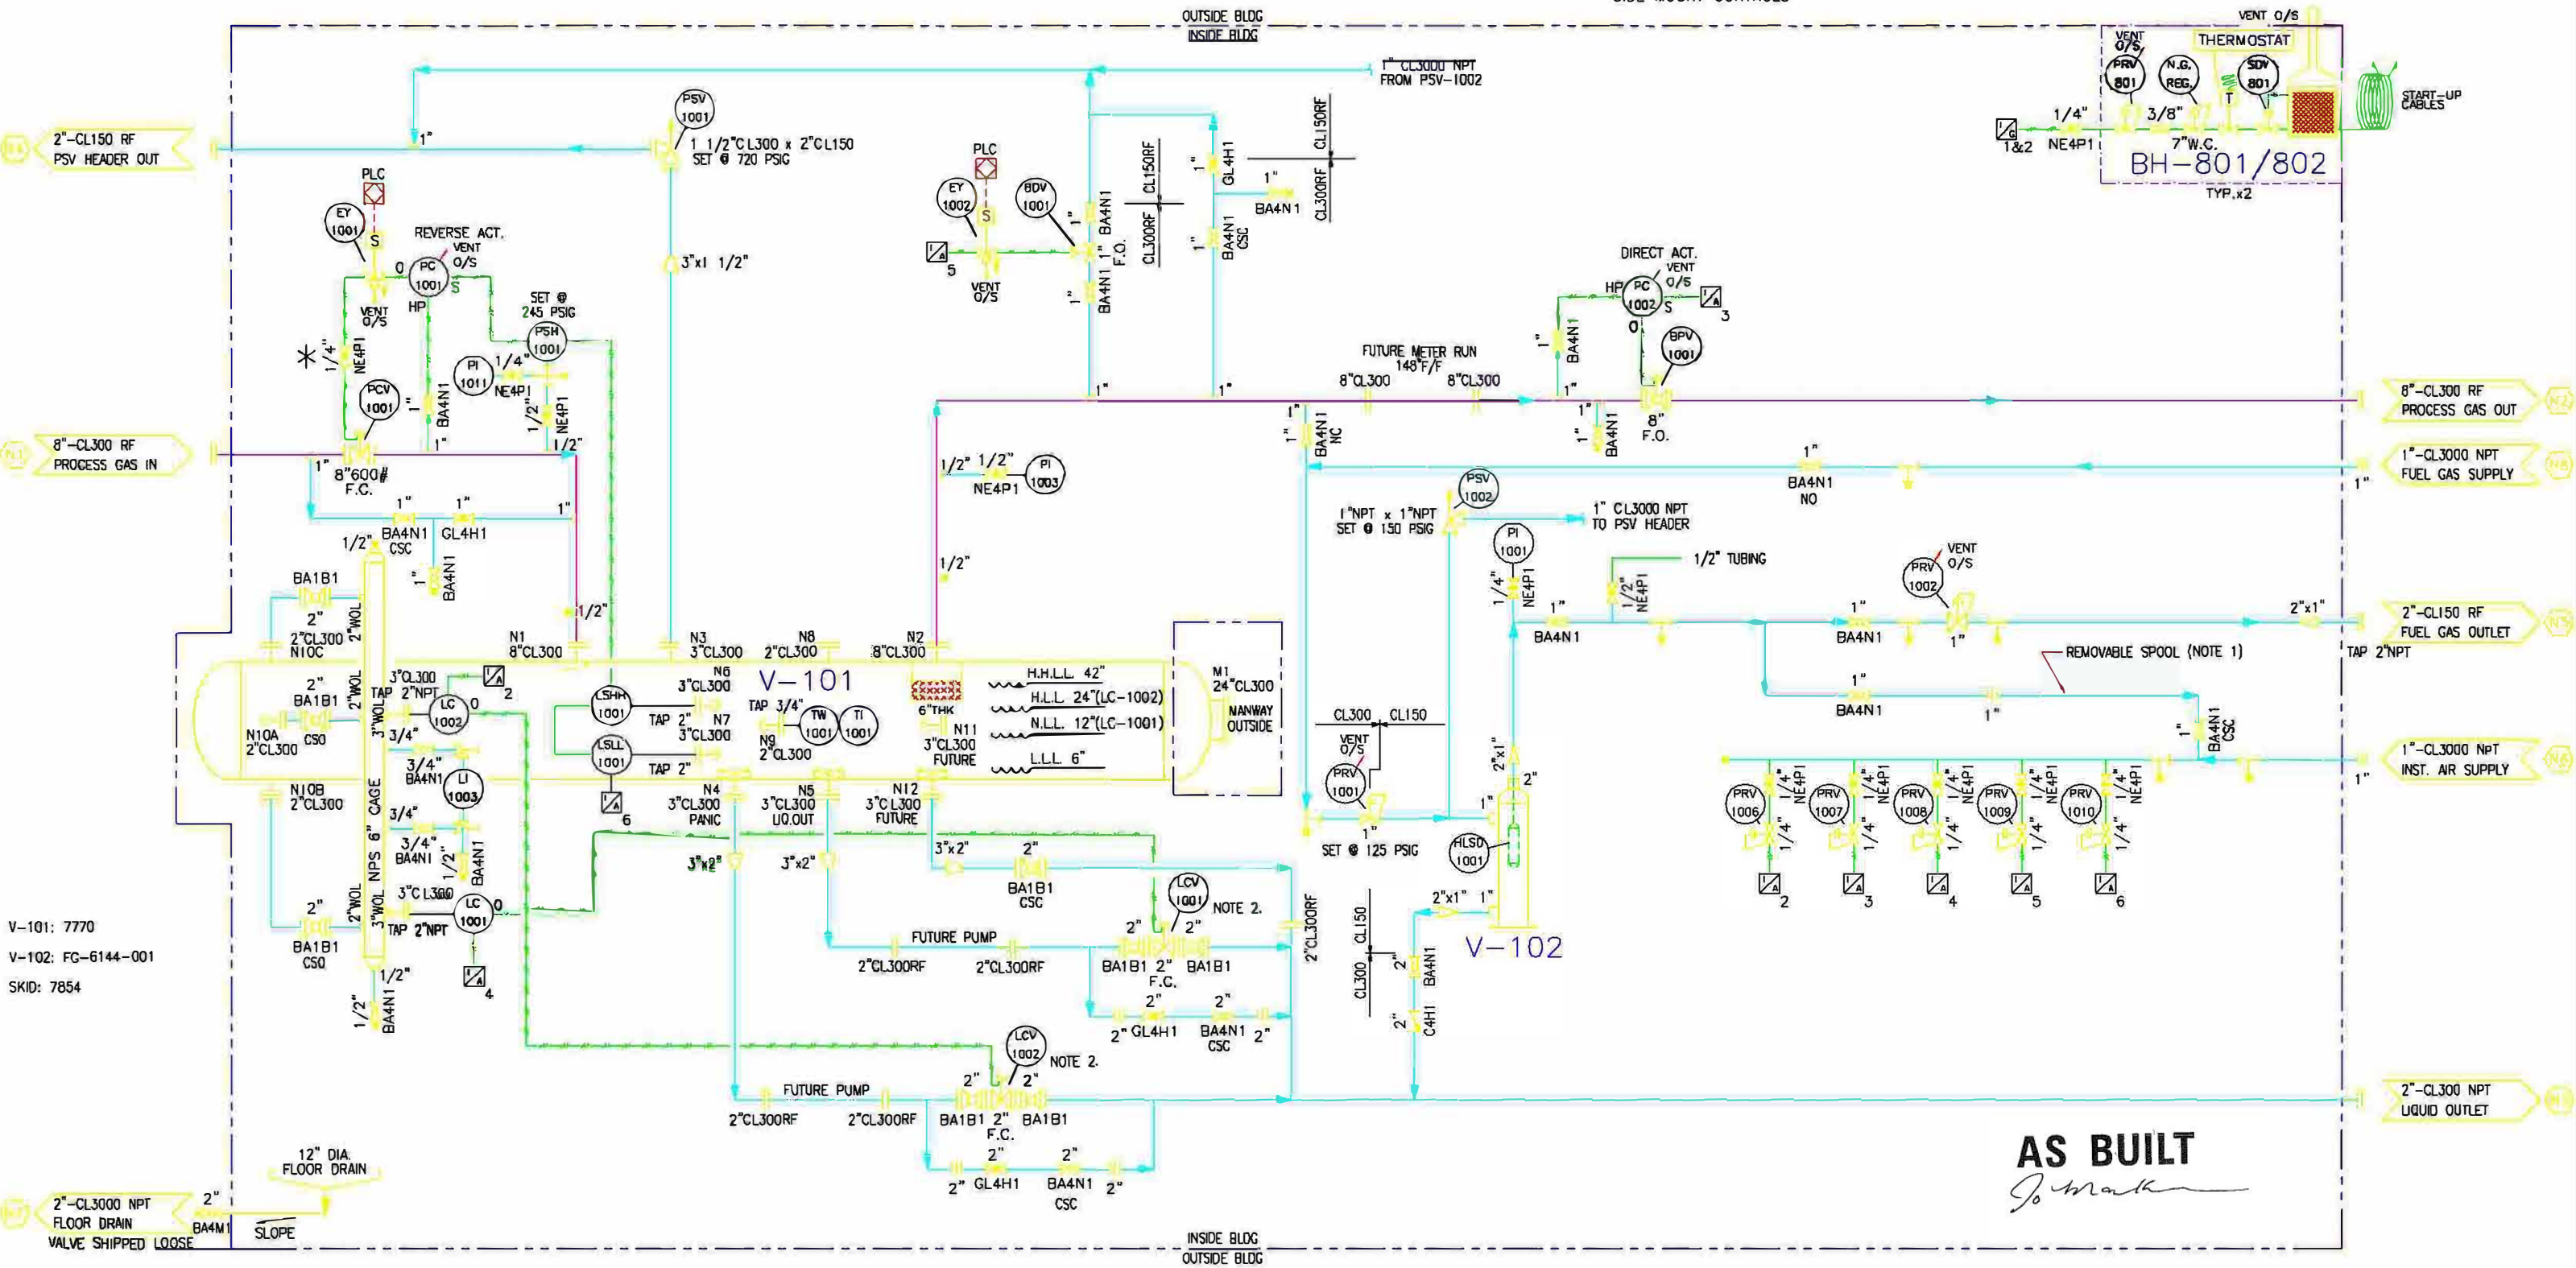

V-101: 7770
V-102: FG-6144-001
SKID: 7854

STAMPS & APPROVALS

NOTES:

- SPOOL PIECE TO BE REMOVED BY CUSTOMER IN FIELD IF SITE HAS AN INSTRUMENT AIR SUPPLY.
- VALVES ARE CL600 AND WILL BOLT UP BETWEEN TWO (2) CL300 BALL VALVES.

LAST SAVED ON: Monday, January 14, 2008 12:39:45 PM by jo markusson
PRINTED ON: Monday, January 14, 2008 1:00:03 PM
R:\PID\7852PID


2	08/01/02	REV AS PER MARK UPS	CZ
1	07/12/19	REV AS PER HEATER	JM
0	07/11/22	ISSUED FOR CONSTRUCTION	AL
F	07/11/14	REV AS PER CUSTOMER	CZ
E	07/11/01	REV AS PER CUSTOMER	AL
D	07/10/26	REVISED PSV HEADER PER LAYOUT FITUP	PP
C	07/10/25	REVISED AS PER CUSTOMER REQUEST	CP
B	07/10/15	REVISED AS PER MARKUP	PP
3	08/01/09	AS BUILT	JM
NO.	DATE	REVISIONS	DWN CHK'D APP.

Paintearth
ENERGY SERVICES INC.

THIS DRAWING IS THE PROPERTY OF PAINTHEARTH ENERGY SERVICES INC. ANY UNAUTHORIZED USE OR REPRODUCTION OF THIS DESIGN OR DRAWING WITHOUT WRITTEN AUTHORIZATION IS STRICTLY PROHIBITED.

DATE: 2007/10/12
DESIGNED BY: PES
DRAWN BY: P.PIOT
CHECKED BY:
APPROVED BY:
SCALE: N.T.S.

CUSTOMER: COMPTON PETROLEUM CORP. c/o O'ROURKE ENGINEERING LTD.
TITLE: PROCESS & INSTRUMENTATION DIAGRAM FOR 60"ID x 20'-0" S/S 2-PH HORIZONTAL VESSEL 720 PSIG @ 130°F c/w 1/8" C.A.
PROJECT NO.: 7852
SHEET NO.: 1 OF 1
FILE NAME: 7852PID
DRAWING NO.: PES-7852PID
REV. NO.: 3

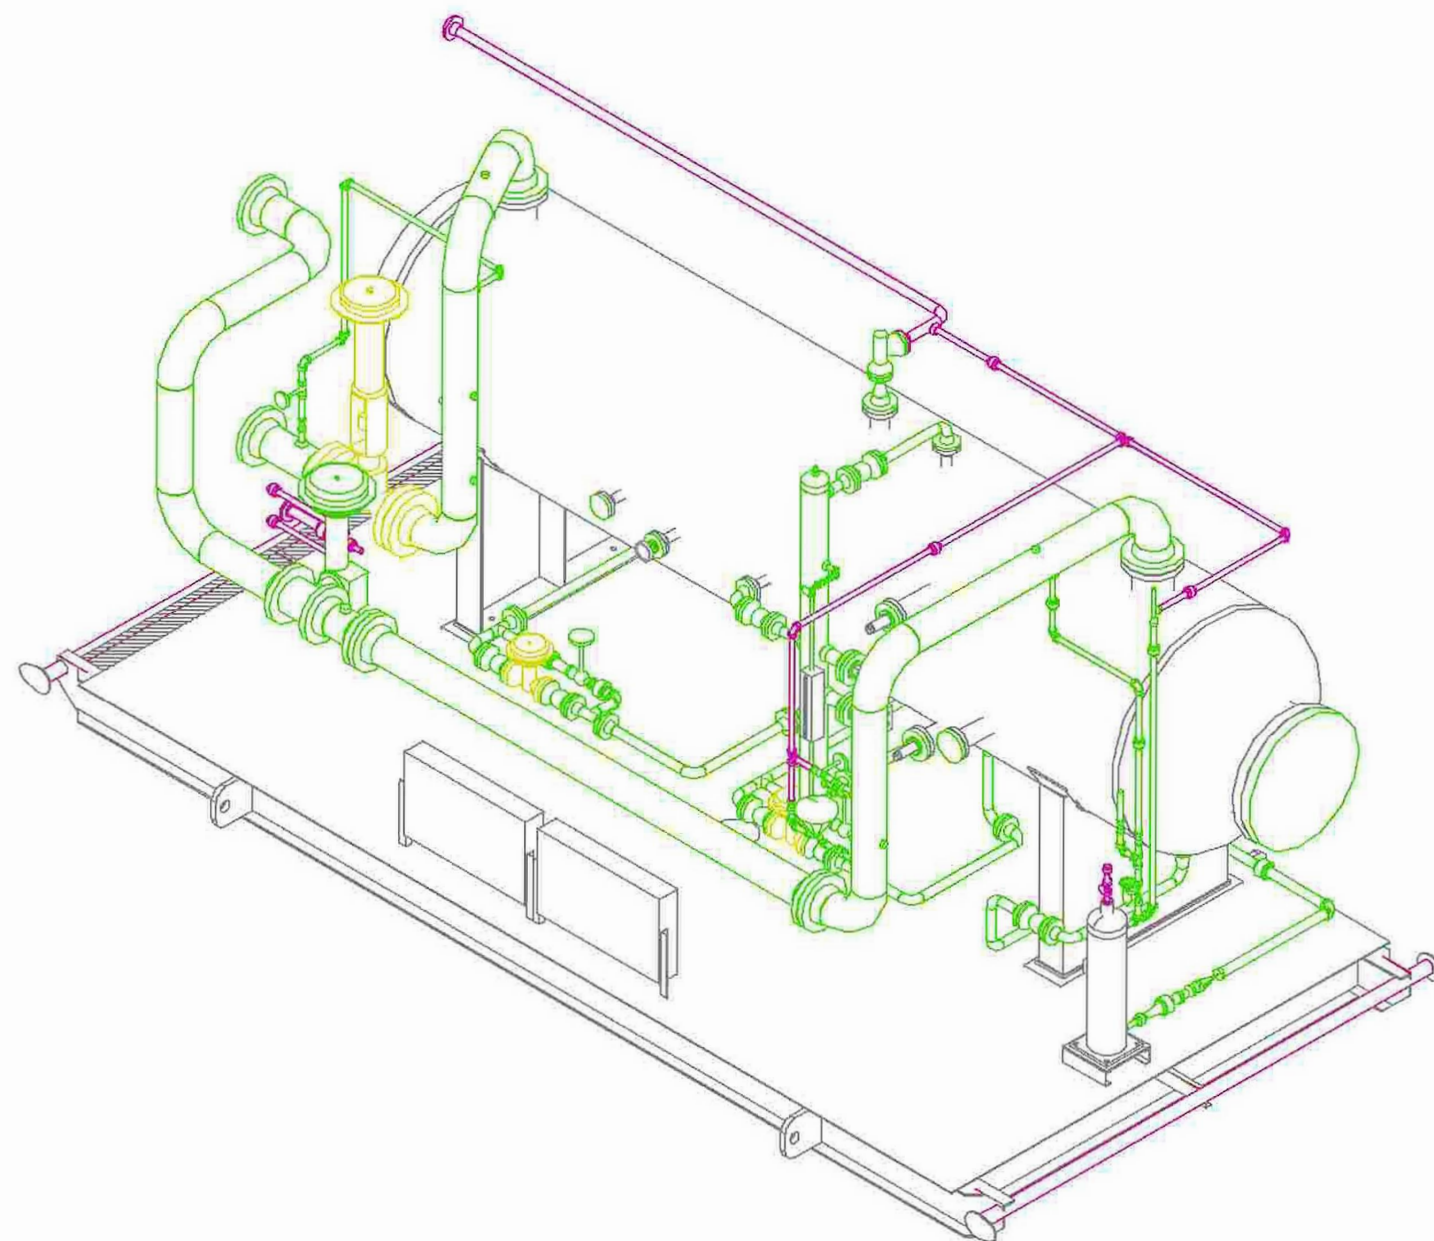

Jo Math

 Paintearth ENERGY SERVICES INC. THIS DRAWING IS THE PROPERTY OF PAINTEARTH ENERGY SERVICES INC. ANY UNAUTHORIZED USE OR REPRODUCTION OF THIS DESIGN OR DRAWING WITHOUT WRITTEN AUTHORIZATION IS STRICTLY PROHIBITED.	DATE 2007/10/12	CLIENT COMPTON PETROLEUM CORP. c/o O'ROURKEENGINEERING LTD.
	DESIGNED BY PES	PROJECT NO. 7852
	DRAWN BY TF	FILE NAME 7852GAISO
	CHECKED BY -	REFERENCE NO. -
	APPROVED BY -	SHEET NO. 3 OF 3
	SCALE N.T.S.	DRAWING NO. PES-7852GAISO
TITLE ASSEMBLY / LAYOUT FOR 60"ID x 20'-0" S/S, 2-PH HORIZONTAL VESSEL c/w 12'-0" WIDE x 24'-0" LONG BUILDING		
TOLERANCES UNLESS OTHERWISE SPECIFIED: FRACTIONS DECIMALS 1/8" 0.03125" 1/16" 0.015625" 3/32" 0.009375" 1/4" 0.00390625" 1/2" 0.001953125" 1" 0.0009765625"		